



Purchasing Department
140 Stonewall Avenue West, Ste 204
Fayetteville, GA 30214
Phone: 770-305-5420
www.fayettecountygov.gov

March 25, 2025

**Subject: RFQ #2583-A: Public Defender Office Flooring
Addendum #1**

Gentlemen/Ladies:

Below, please find responses to questions, clarification, or additional information for the above referenced **RFQ**. You will need to consider this information when preparing your quote.

- 1. What type of material would you like to use to transition from the tile to the LVP? What color?** Standard transition. Matching the LVP.
- 2. What LVP thickness should the contractor quote, 6mil or 20 mil?** 20 Mil Anvil plus 20 2357V
- 3. Should the contractor add trim between the base board and TVP?** If you mean quarter round, yes.
- 4. If quarter round molding is used, what color should the contractor use?** Glass white.
- 5. Should the contractor paint the quarter round?** Yes.
- 6. Do the baseboards require painting?** They are already painted.
- 7. Please see the new floor plan mark-up.**

Received by (Name): _____ Company _____


Note: If this addendum is not returned to the Fayette County Purchasing Department or returned and not signed, responding individuals, companies or other organizations will still be responsible for the requirements of this addendum and the specifications or changes herein.

The opening date for this RFQ has not changed. **The opening time and date are Tuesday, April 29, 2025, at 3:00pm.** Quotes must be received by the Purchasing Department at the address above, Suite 204, at or before the opening date and time.

The deadline for inquiries has passed, so the Purchasing Department will not be able to accept any additional questions after this time.

If you have questions, please contact Sherry White, Senior Contract Administrator at (770) 305-5314, fax (770) 719-5544 or email at swhite@fayettecountyga.gov .

Sincerely,

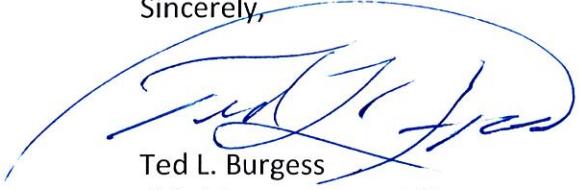


Ted L. Burgess
Chief Procurement Officer



C

AC

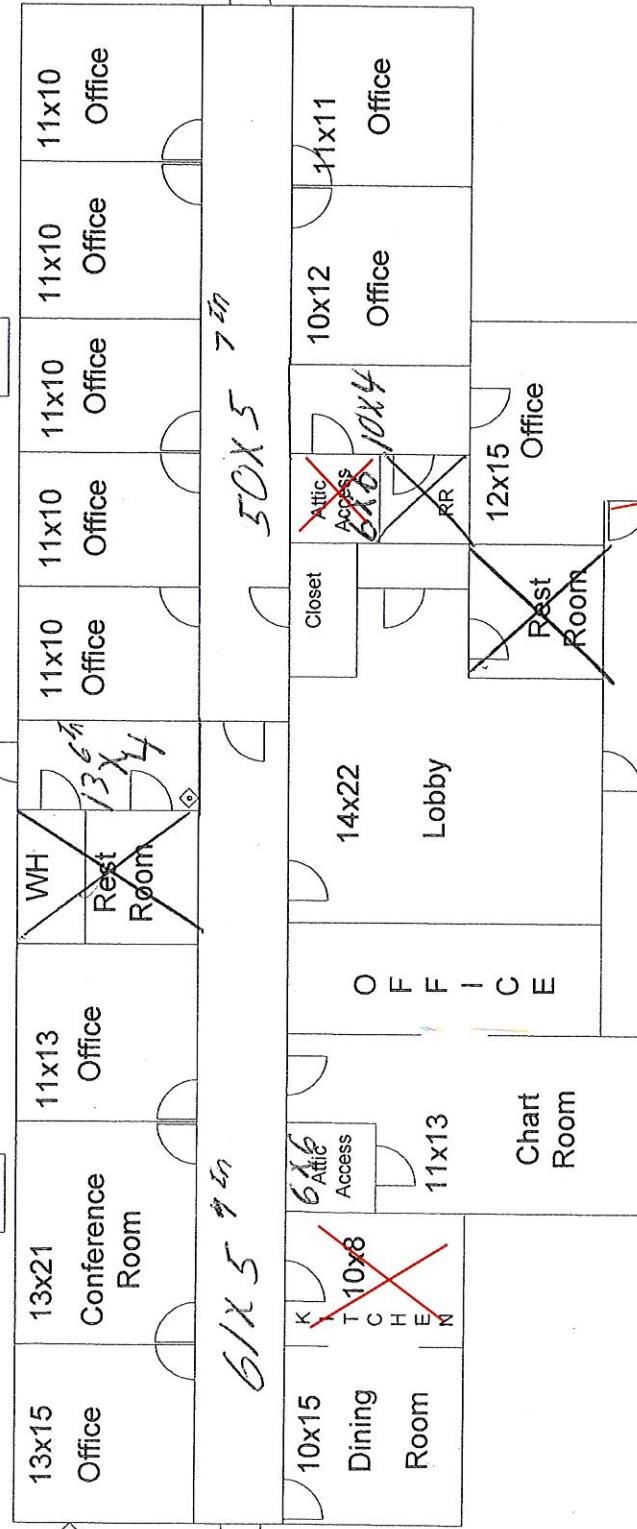

B

D

Tile will be removed by county.

A

Hydrant is 300 feet north
of driveway on Bradley
Drive

FCP	Fire Alarm Control Panel	QCP	2-Way FDC	Gas Line Meter	Automatic Sprinkler - Fully Sprinklered	Emergency Light
AK	Keys		Single Door	Hydrant	Non - Sprinklered	RV
AS	Q.S. & Valve		electrical panel		Partially Sprinklered	Fire Door
BS	Bi-Hazard	Hazard	Doors		Overhead Door	Fuel Pump
RA	Radioactive	Scuttle Hole	2 Line Road		Dimension Line	LP Tank
		Attic Access				



715 Bradley Drive

Drawing by: Lt. Hartley
Reviewed: Lt. Hartley
03/07/24
SCALE: None